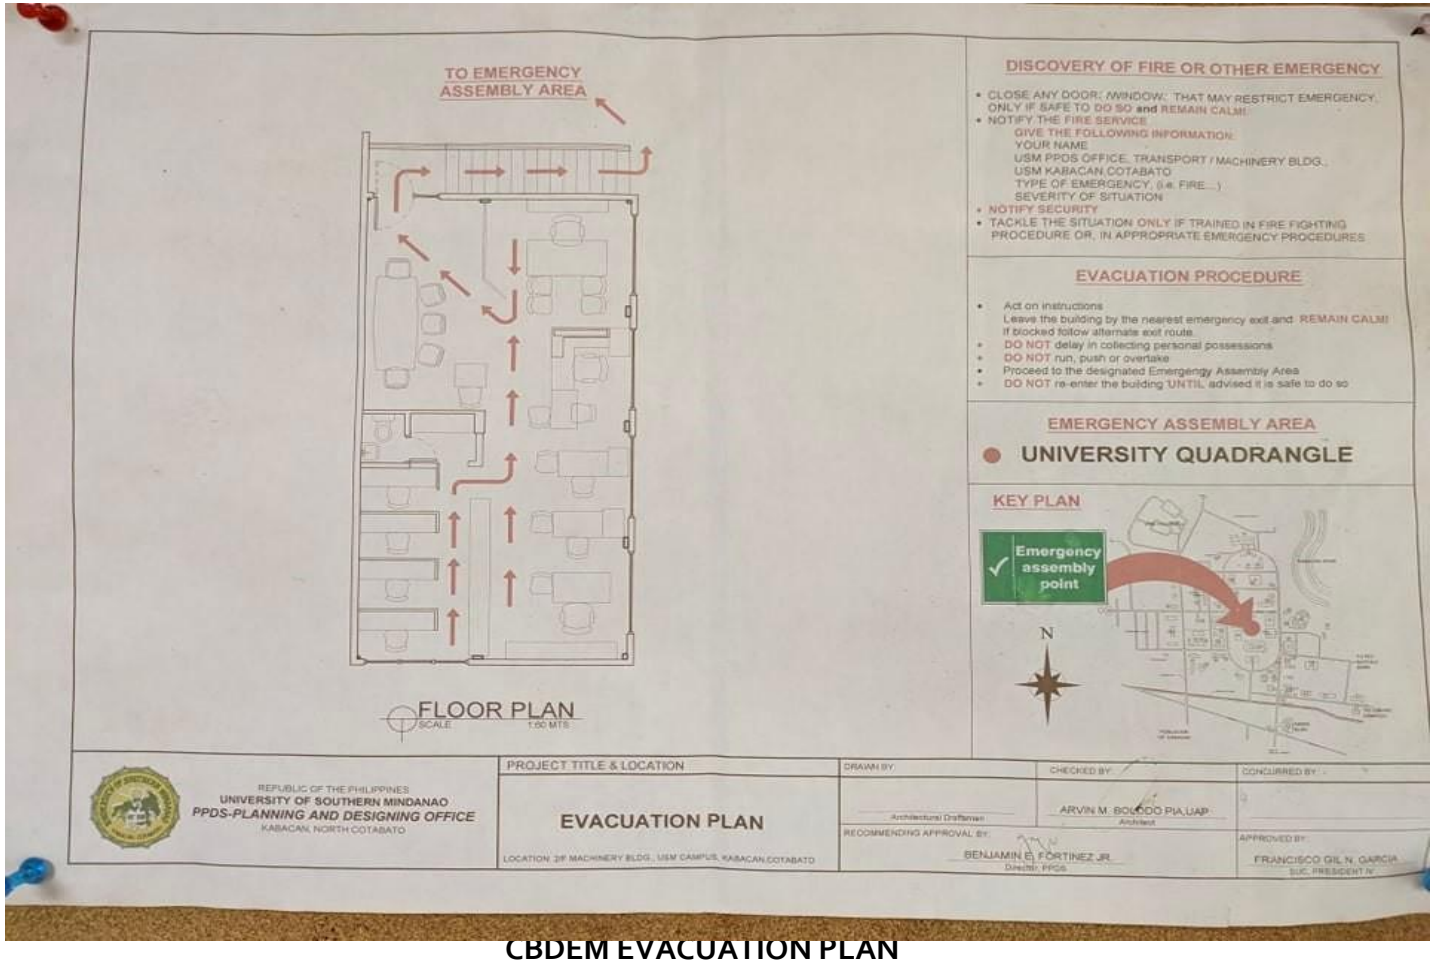
AREA VIII

PHYSICAL PLANT AND FACILITIES

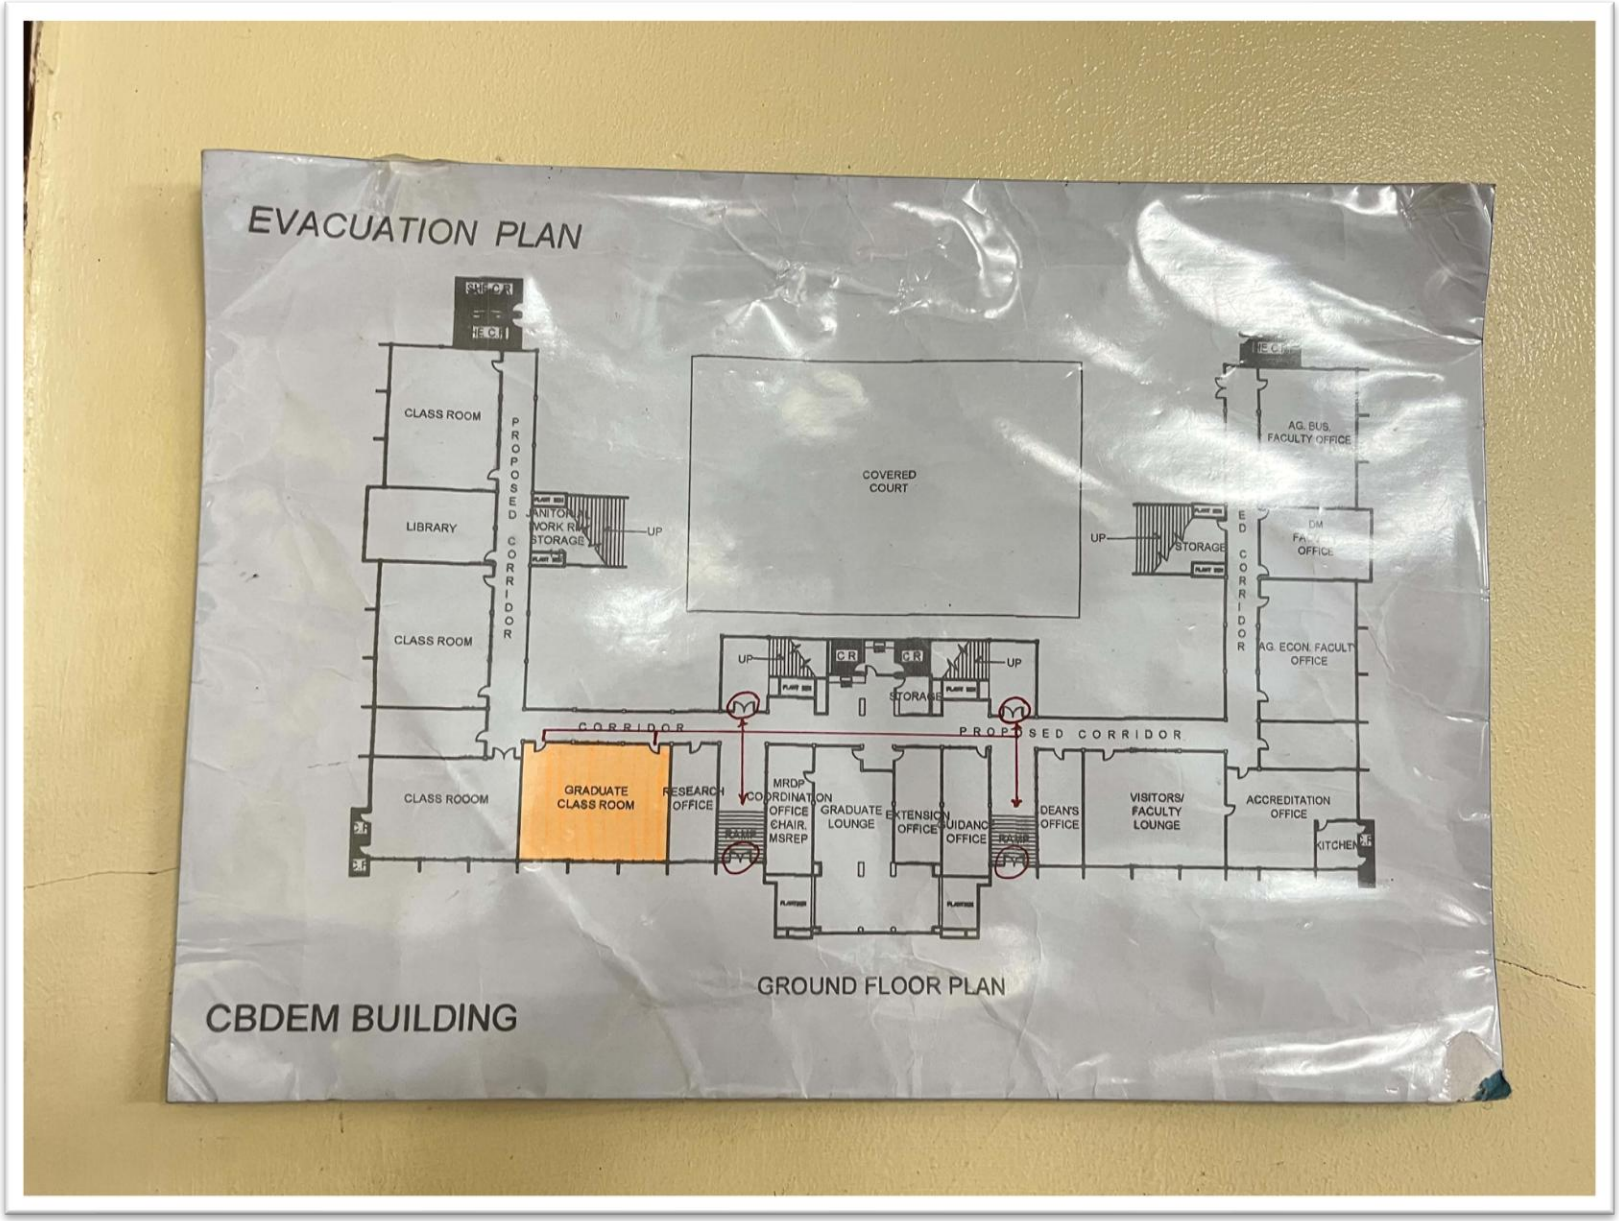
I.6. FLOOR PLANS INDICATING FIRE EXITS AND LOCATION OF FIREFIGHTING EQUIPMENT, STANDPIPES, AND OTHER WATER SOURCES ARE CONSPICUOUSLY DISPLAYED IN EACH BUILDING.

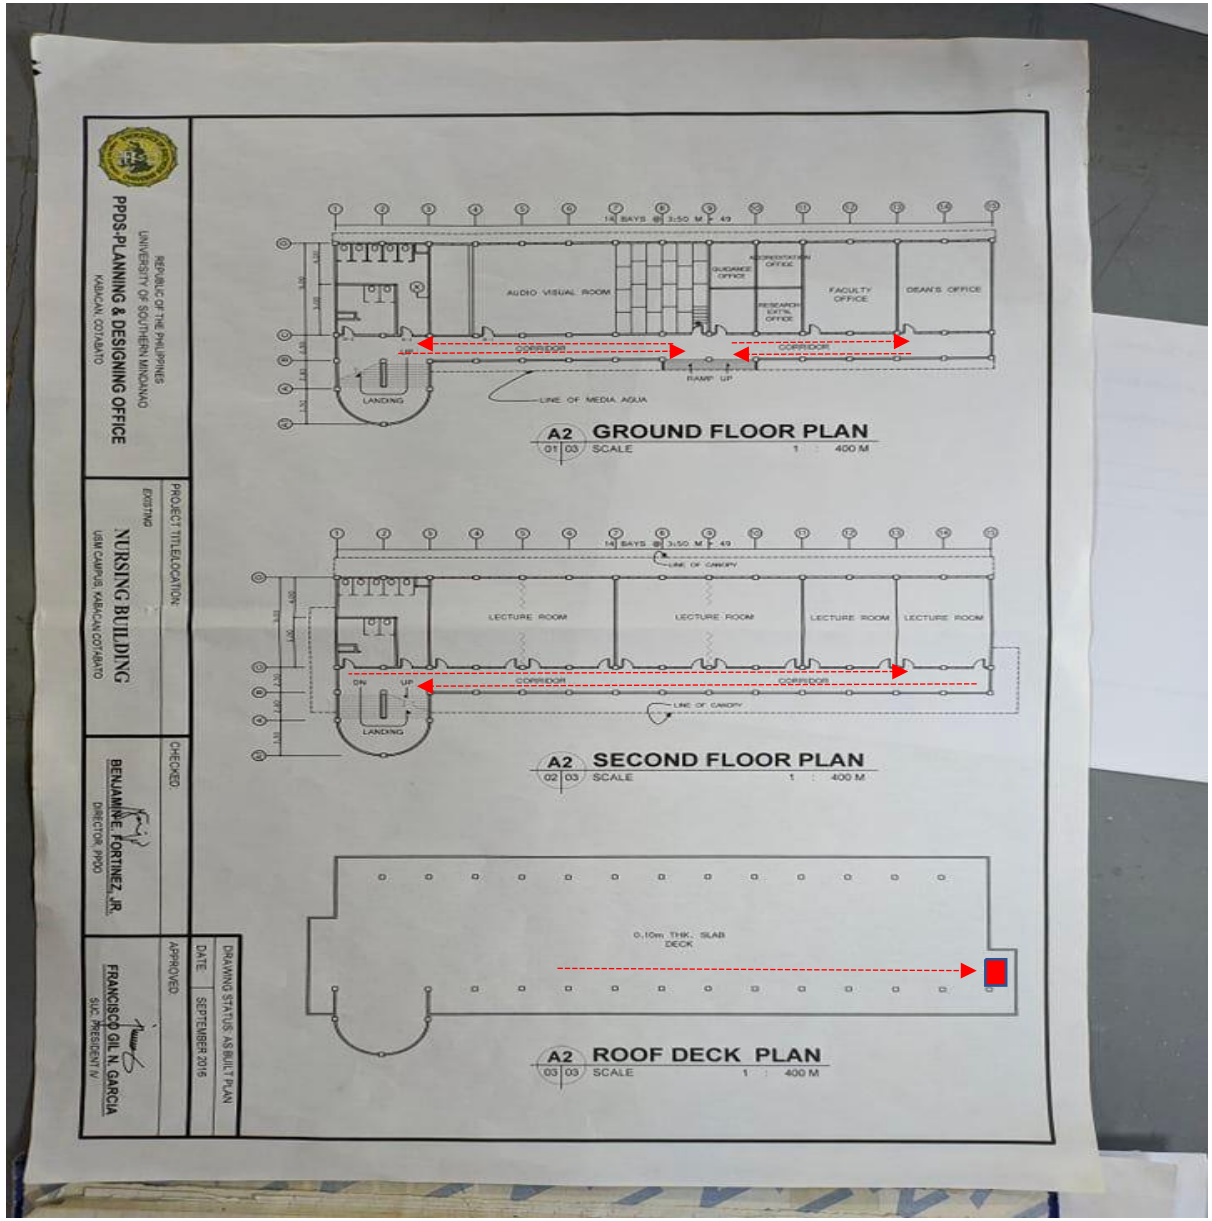
I.6. Floor plans indicating fire exits and location of firefighting equipment, standpipes, and other water sources are conspicuously displayed in each building.

CAMPUS EVACUATION PLAN



CBDEM EVACUATION PLAN


EVACUATION PLAN
CLASS ROOM
LIBRARY
CLASS ROOM
CLASS ROOM
PROPOSED CORRIDOR
COVERED COURT
UP
STORAGE
CR
CR
STORAGE
UP
UP
STORAGE
E D CORRIDOR
AG. BUS. FACULTY OFFICE
AG. ECON. FACULTY OFFICE
CORRIDOR
PROPOSED CORRIDOR
GRADUATE CLASS ROOM
RESEARCH OFFICE
MRDP COORDINATION OFFICE CHAIR, MSREP
GRADUATE LOUNGE
EXTENSION OFFICE
GUIDANCE OFFICE
DEAN'S OFFICE
VISITORS/ FACULTY LOUNGE
ACCREDITATION OFFICE
KITCHEN
GROUND FLOOR PLAN
CBDEM BUILDING


REPUBLIC OF THE PHILIPPINES
UNIVERSITY OF SOUTHERN MINDANAO
PPDS-PLANNING & DESIGNING OFFICE
KABACAN, COTABATO
PROJECT TITLE/LOCATION:
EXISTING
NURSING BUILDING
USM CAMPUS, KABACAN COTABATO
CHECKED:
BENJAMIN E. FORTINEZ, JR.
DIRECTOR, PPDO
APPROVED:
FRANCISCO GIL N. GARCIA
SUC PRESIDENT IV
DRAWING STATUS: AS BUILT PLAN
DATE: SEPTEMBER 2016
AUDIO VISUAL ROOM
GUIDANCE OFFICE
ADMINISTRATION OFFICE
RESEARCH EXTNL OFFICE
FACULTY OFFICE
DEAN'S OFFICE
CORRIDOR
RAMP UP
LANDING
LINE OF MEDIA AGUA
A2 GROUND FLOOR PLAN
01 03 SCALE 1 : 400 M
LECTURE ROOM
LECTURE ROOM
LECTURE ROOM
LECTURE ROOM
LINE OF CANOPY
DN
UP
A2 SECOND FLOOR PLAN
02 03 SCALE 1 : 400 M
0.10m THK. SLAB DECK
A2 ROOF DECK PLAN
03 03 SCALE 1 : 400 M





FIRE EXTINGUISHERS AND EMERGENCY HOTLINES

FIRE EXTINGUSHER ARE LOCATED ON EVERY CORNER OF THE BUILDING






PAPA
TEACHER
FREEDOM WALL
RITE WHAT YOU SEE
AND FEEL
WEAN
NARRATOR
ABBY
DRY CHEMICAL
STORED PRESSURE TYPE

FIRE HOSE

