

AREA VIII

PHYSICAL PLANT AND FACILITIES


S.2. THE CLASSROOM IS WELL-LIGHTED, VENTILATED, AND CONDITIONED.

S.2. The classroom is well-lighted, ventilated, and conditioned.

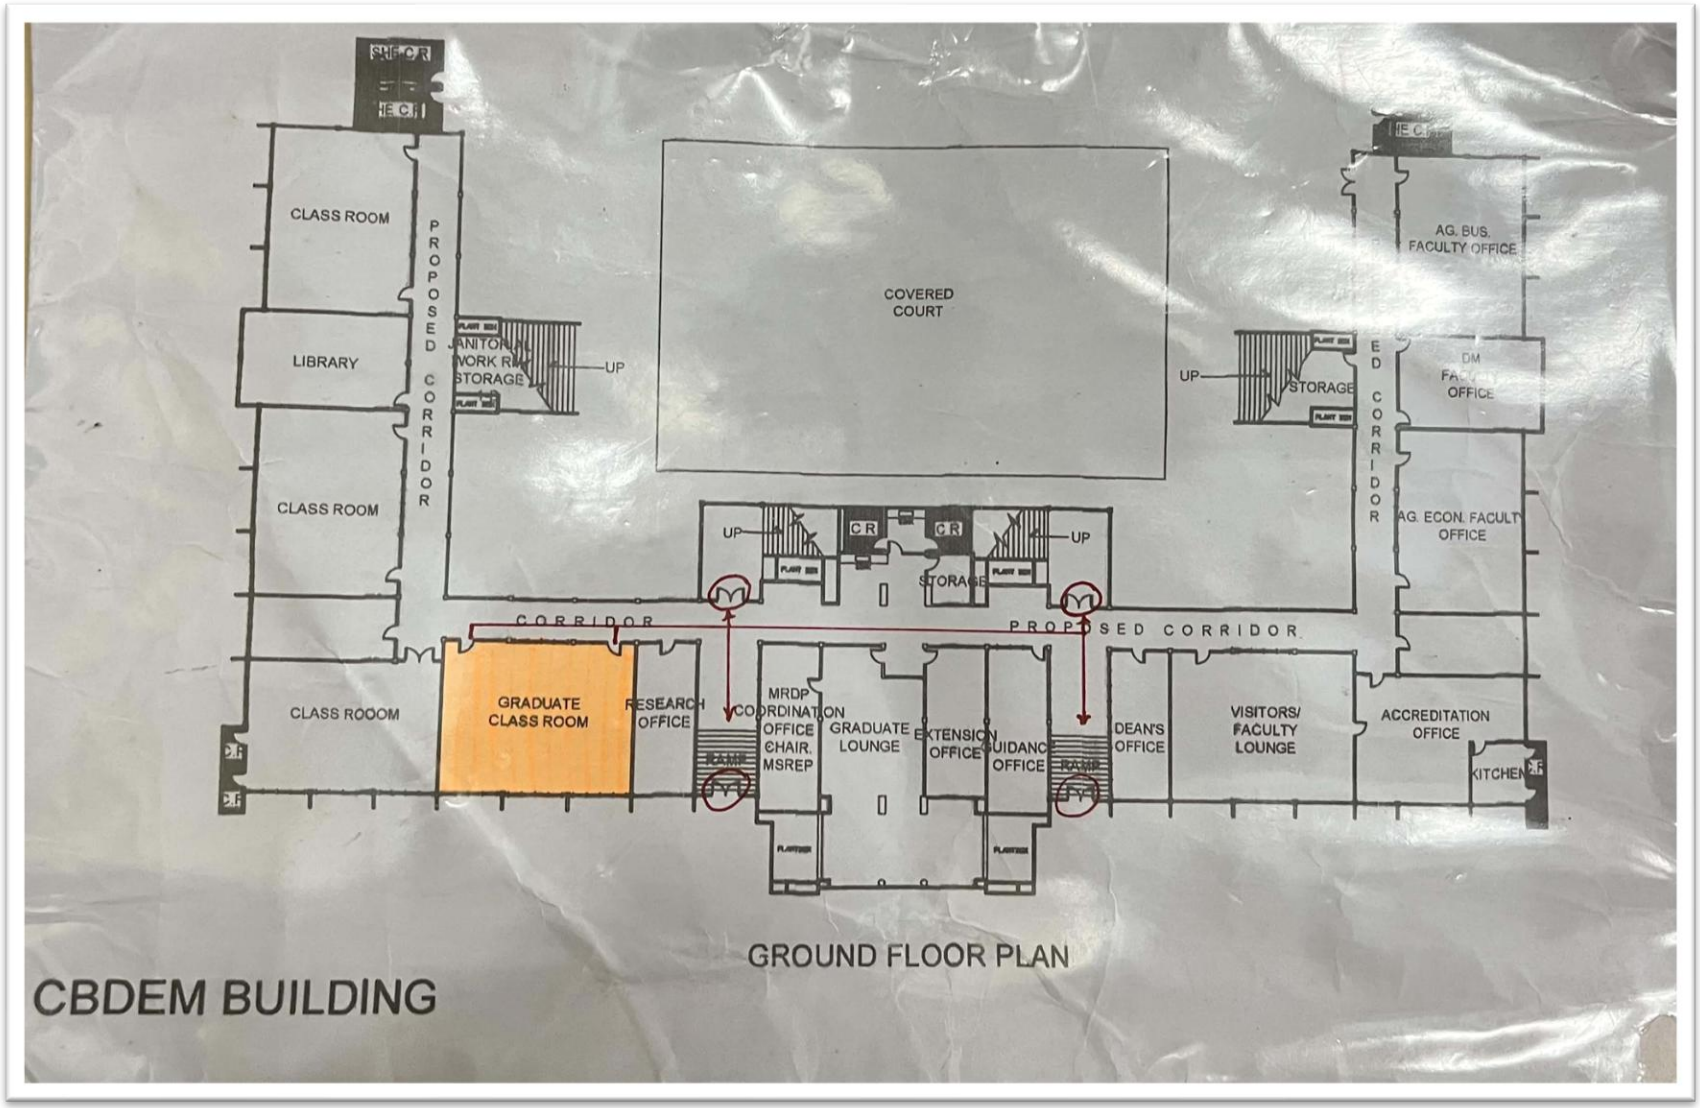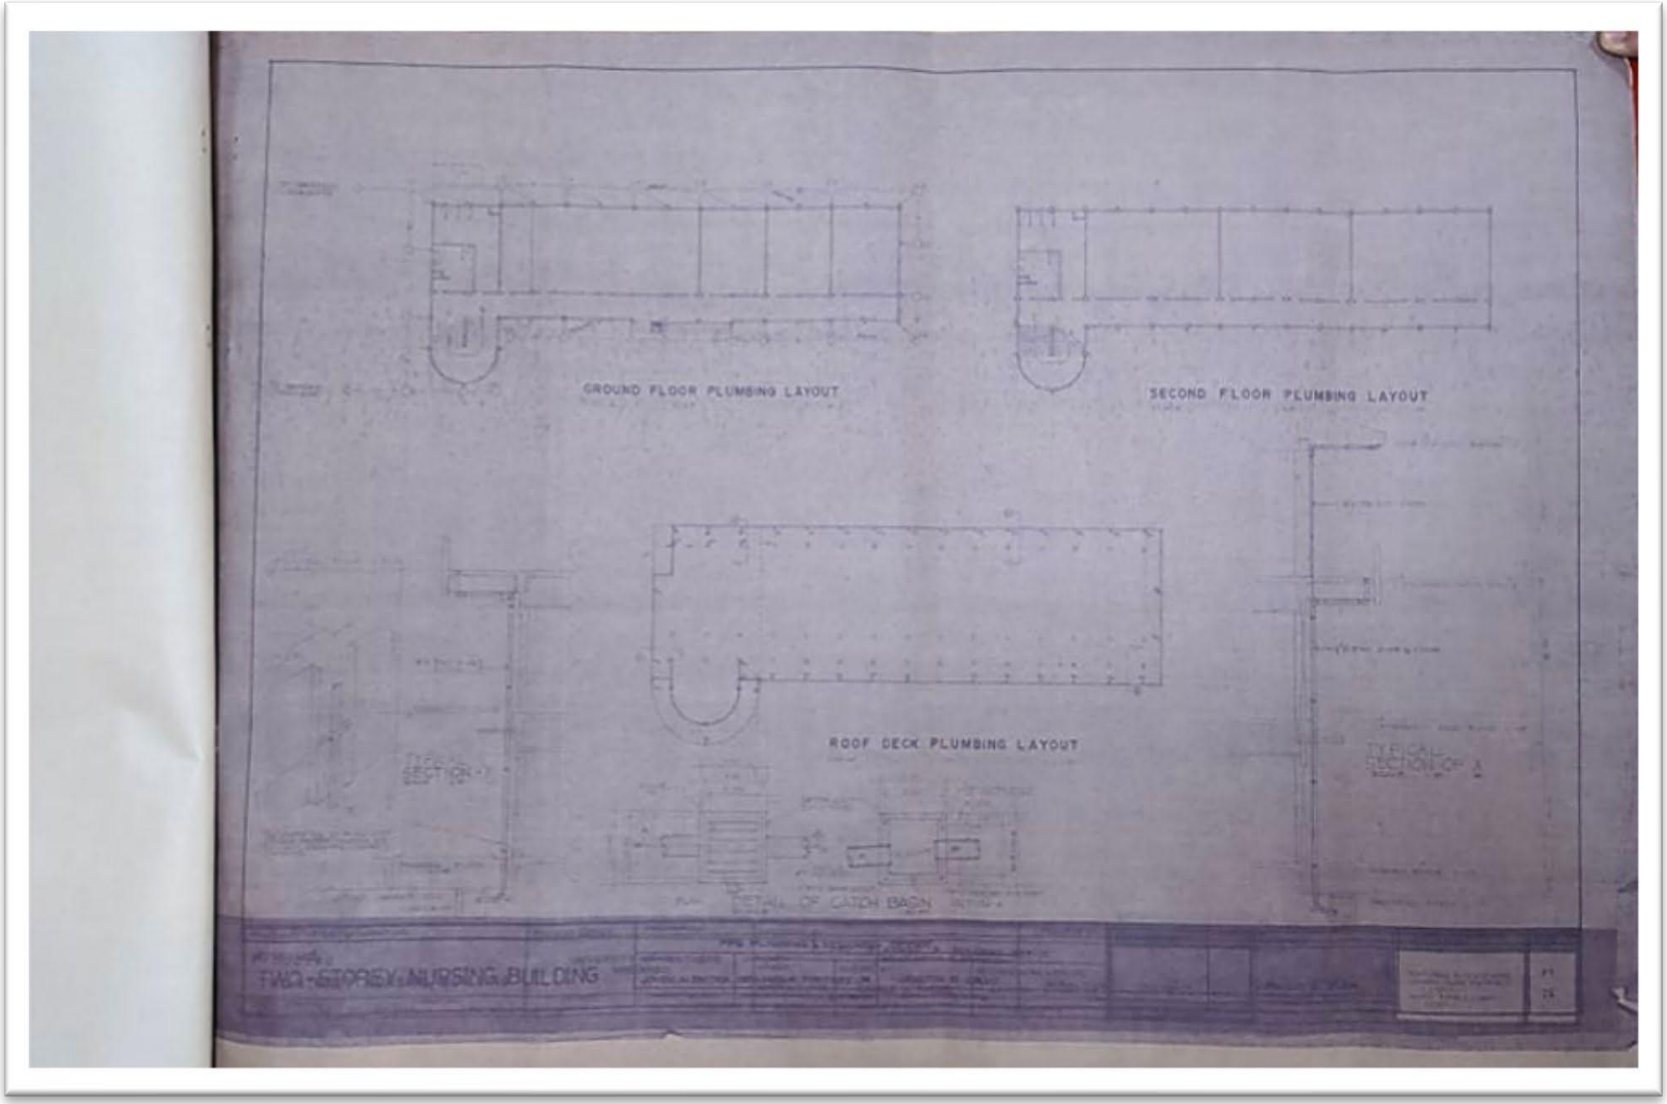


GROUND FLOOR PLUMBING LAYOUT
SECOND FLOOR PLUMBING LAYOUT
ROOF DECK PLUMBING LAYOUT
DETAIL OF CATCH BASIN
TWO-STOREY NURSING BUILDING


NORTH
COLLEGE OF NURSING
29/09/2016
DEVELOPMENT PLAN
PERSPECTIVE
DRAWING STATUS: AS BUILT PLAN
DATE: SEPTEMBER 2016
REPUBLIC OF THE PHILIPPINES
UNIVERSITY OF SOUTHERN MINDANAO
PPDS-PLANNING & DESIGNING OFFICE
KABACAN, COTABATO
PROJECT TITLE/LOCATION:
EXISTING
NURSING MAIN BUILDING
USM CAMPUS, KABACAN COTABATO
CHECKED:
BENJAMIN E. FORTINEZ, JR.
DIRECTOR, PPDO
APPROVED:
FRANCISCO GIL N. GARCIA
SUC PRESIDENT IV

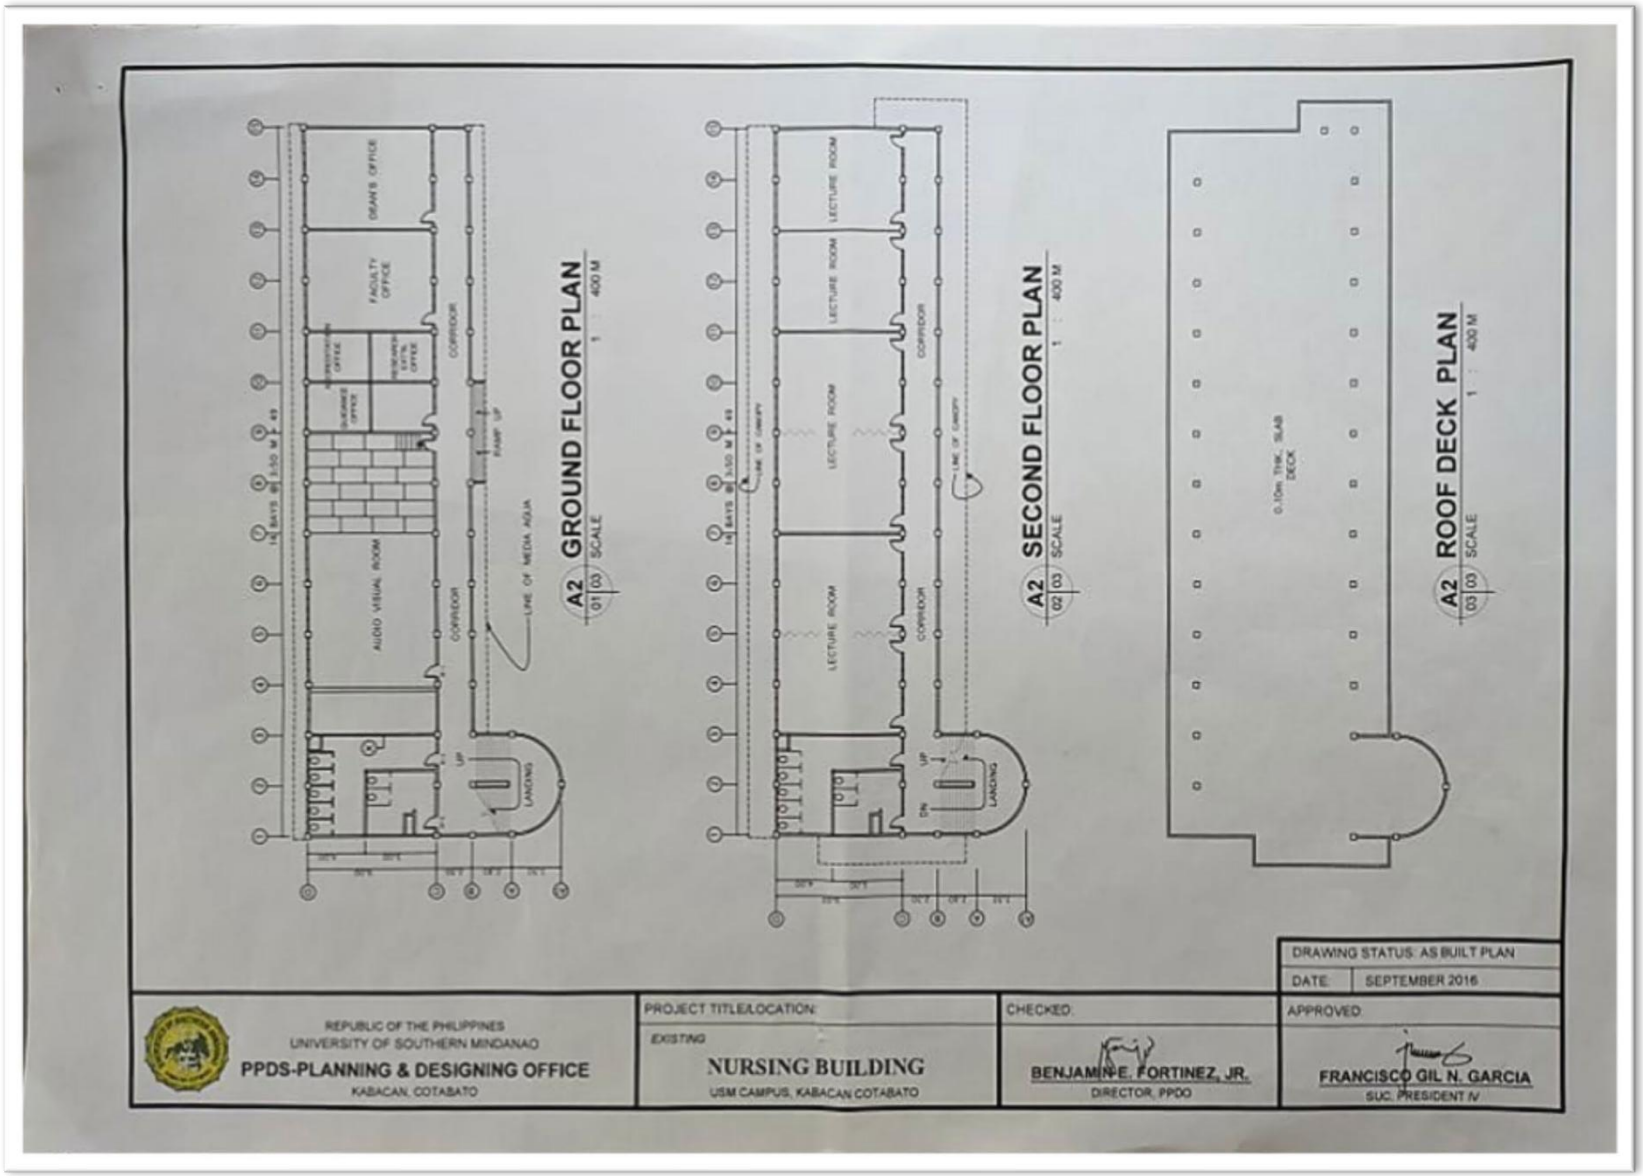
A2 GROUND FLOOR PLAN
01 03 SCALE 1 : 400 M
A2 SECOND FLOOR PLAN
02 03 SCALE 1 : 400 M
A2 ROOF DECK PLAN
03 03 SCALE 1 : 400 M
DEAN'S OFFICE
FACULTY OFFICE
AUDIO VISUAL ROOM
CORRIDOR
LECTURE ROOM
LANDING
RAMP UP
LINE OF MEDIA AGUA
0.10m THK. SLAB DECK
DRAWING STATUS: AS BUILT PLAN
DATE: SEPTEMBER 2016
REPUBLIC OF THE PHILIPPINES
UNIVERSITY OF SOUTHERN MINDANAO
PPDS-PLANNING & DESIGNING OFFICE
KABACAN, COTABATO
PROJECT TITLE/LOCATION:
EXISTING
NURSING BUILDING
USM CAMPUS, KABACAN COTABATO
CHECKED:
BENJAMIN E. FORTINEZ, JR.
DIRECTOR, PPDO
APPROVED:
FRANCISCO GIL N. GARCIA
SUC PRESIDENT IV

V. INVENTORY OF LABORATORY SUPPLIES & EQUIPMENTS:

No.	UNIT DESCRIPTION	QUANTITY		PROOF OF PURCHASE		REMARKS
		No.	Desc	Receipt #	Date	
1	Ambu Bag	4	unit	164-233-0072	4/14/2006	
2	Autoclave SN#AS-2201	1	unit	164-233-0080	3/14/2006	
3	Bedsdie Table: Paragon type, formica top w/ guard rails, provided w/ one center drawer & 1 compartment w/ removable	10	units	164-22-0120	8/16/2005	
4	BP Apparatus (Aneroid Alp K2) Japan Made	6	units	164-233-0044	7/11/2005	
5	BP Apparatus (Mercury) Japan Made	2	units	164-233-0043	9/23/2005	
6	BP Instrument, Automatic	4	units	11-10-1604	10/10/2011	
7	BP Instruments, Automatic	4	units	1604	10/10/2011	
8	Breast Examination Model	1	unit	TTN-233-0028	1/26/2007	
9	Breast Model	1	unit	TTN-233-0026	1/26/2007	
10	Bulletin Board w/ sliding glass	1	unit		1/17/2011	
11	Cabinet Locker	1	unit	164-222-0109	6/16/2005	
12	Ceiling Fan	8	units	164-221-0208	7/8/2004	
13	Ceiling Fan (Orbit type)	19	units	TTN-221-0313	8/13/2010	
14	Crib w/ Baby doll	2	units	164-233-0052	12/16/2005	
15	D.R. Table	1	unit	164-233-0057	1/10/2006	
16	Data Projector (DLP Projector) U6-132	1	unit	164-221-029	2/29/2008	
17	Delivery Table	1	unit		3/14/2006	
18	Delivery Table	1	unit	164-233-0076	3/14/2006	
19	Display Cabinet	5	units	164-222-0108	6/16/2005	
20	Doppler	2	units	1604	10/10/2011	
21	Doppler	2	units	11-10-1604	10/10/2011	
22	Droplight	1	unit			
23	Emergency cart	1	unit		5/30/2006	
24	Examination Table-Bean type, made of tabular steel frame mounted on rubber tip divided in 3 sections for multipurpose adjustement provided with stirrup and leatherette cushion	1	unit	164-232-0019	9/6/2005	

57	Operating Lamp	1	unit		5/30/2006
58	Opthalmoscope	1	unit	164-233-0060	1/23/2006
59	Opthalmoscope set (China made)	1	unit	164-233-0039	8/16/2005
60	Orthopedic Bed	1	unit	164-233-0061	1/23/2006
61	Osculating Mannequin (Life size) with speakers, with CPU and monitor for programming, with detachable parts for specific normal/abnormal sounds	1	unit	TTN-233-0051	6/4/2009
62	Overhead Table, plain formica table adjustable in height sturdy base mounted on cater wheel	6	units	164-232-0020	9/6/2005
63	Panasonic Desk Fan	1	unit	164-221-0296	6/30/2005
64	Panasonic Orbit Fans	2	units	164-221-0294	6/23/2005
65	Panasonic Orbit Fans	2	units	164-221-0292	6/23/2005
66	Panasonic Orbit Fans	2	units	164-221-0291	6/23/2005
67	Panasonic Orbit Fans	2	units	164-221-0290	6/23/2005
68	Pelvic model w/ baby	1	set	164-233-0056	1/10/2006
69	Penis Model	3	units	TTN-233-0025	1/26/2007
70	Ressusi-ann (Whole body with skill guide)	1	unit	LCL-233-0059	5/16/2007
71	Scissors	20	pairs		7/31/2006
72	Scissors, bandage	6	pairs		6/23/2006
73	Scissors, irish	10	pairs	1400	12/11/2006
74	Scissors, mayo	10	pairs	1400	12/11/2006
75	Scissors, operating	10	pairs	1400	12/11/2006
76	Scissors, straight	20	pairs		7/31/2006
77	Skeleton, Disarticulated painted full A05/2	1	unit		7/14/2008
78	Skin section, 200 times full size VK 526	1	unit		7/14/2008
79	Skull, A20 classic skull w/ new brain, 8 parts	1	unit		7/14/2008
80	Skull, A21 numbered classic	1	unit		7/14/2008
81	Speculum	2	sets		7/31/2006
82	Steel Cabinets (4 drawers)	1	unit	164-221-0309	7/16/2005
83	Sterilizer	2	units	164-233-0053	12/16/2005
84	Stethoscope Japan Made	6	pcs	164-233-0045	7/11/2005
85	Stretcher, HD	1	unit	164-232-0016	1/12/2006
86	Study Chairs scholar, OBT MWH	15	units	164-222-0112	7/27/2005
87	Suction Machine	1	unit	164-233-0064	1/23/2006
88	Surgical Bed	1	unit	164-233-0065	1/23/2006

WORKPLAN AND BUDGET
CY 2021

Department/Unit:

CODE	OBJECT OF EXPENDITURE	SCHEDULE/MILEDSTONE OF ACTIVITIES											
		1st Quarter		2nd Quarter			1st Quarter			4th Quarter			TOTAL
	MAINTENANCE AND OTHER OPERATING EXPENSES	Feb	March	April	May	June	July	August	Sept.	Oct.	Nov.	Dec	
	Repair & Maintenance-School Building	0	0	0	0	0	0	0	0	0	0	0	0
	Repair & Maintenance-Other Structure	0	0	0	0	0	0	0	0	0	0	0	0
	Repair & Maintenance-Office Equipment	0	0	0	0	0	0	0	0	0	0	0	0
	Repair & Maintenance-IT Equipment	0	0	0	0	0	0	0	0	0	0	0	0
	Repair & Maintenance-Hospital Equipment	0	0	0	0	0	0	0	0	0	0	0	0
	Repair & Maintenance-Sports Equipment	0	0	0	0	0	0	0	0	0	0	0	0
	Repair & Maintenance-Technical & Scientific Equipment	0	0	0	0	0	0	0	0	0	0	0	0
	Repair & Maintenance-Furniture & Fixture	0	0	0	0	0	0	0	0	0	0	0	0
	Repair & Maintenance-Motor Vehicles	0	0	0	0	0	0	0	0	0	0	0	0
	Fidelity Bonds	0	0	0	0	0	0	0	0	0	0	0	0
	Other MOOE	0	0	0	0	0	0	0	0	5000	9550	13300	27850
	Total MOOE	0	0	0	0	0	0	0	0	9000	9550	13300	172420
CAPITAL OUTLAY													
	Building	0	0	0	0	0	0	0	0	0	0	0	0
	Office Equipment	0	0	0	0	0	0	0	0	0	0	0	0
	Furniture & Fixture	0	0	0	0	0	0	0	0	0	0	0	0
	ICT Equipment	0	0	0	0	0	0	0	0	0	6000	0	6000
	ICT Software (License)	0	0	0	0	0	0	0	0	0	0	0	0
	Medical, Dental & Laboratory Equipment	0	0	0	0	0	0	0	0	0	0	0	0
	Sports Equipment	0	0	0	0	0	0	0	0	0	0	0	0
	Printing Equipment	0	0	0	0	0	0	0	0	0	0	0	0
	Technical & Scientific Equipment	0	0	0	0	0	0	0	0	0	0	0	0
	Other Machineris & Equipment	0	0	0	0	0	0	0	0	0	0	0	0
	Books	0	0	0	0	0	0	0	0	0	0	0	0
	Total MOOE	0	0	0	0	0	0	0	0	0	6000	0	6000
	TOTAL	0	0	0	0	0	0	0	0	9000	15550	13300	178420

Prepared by: Certified by: Reviewed by: Recommending Approval: Approved By:

BABY-NASHAIMA B. PETRON MARIANNE E. MERIALES

Page 2



