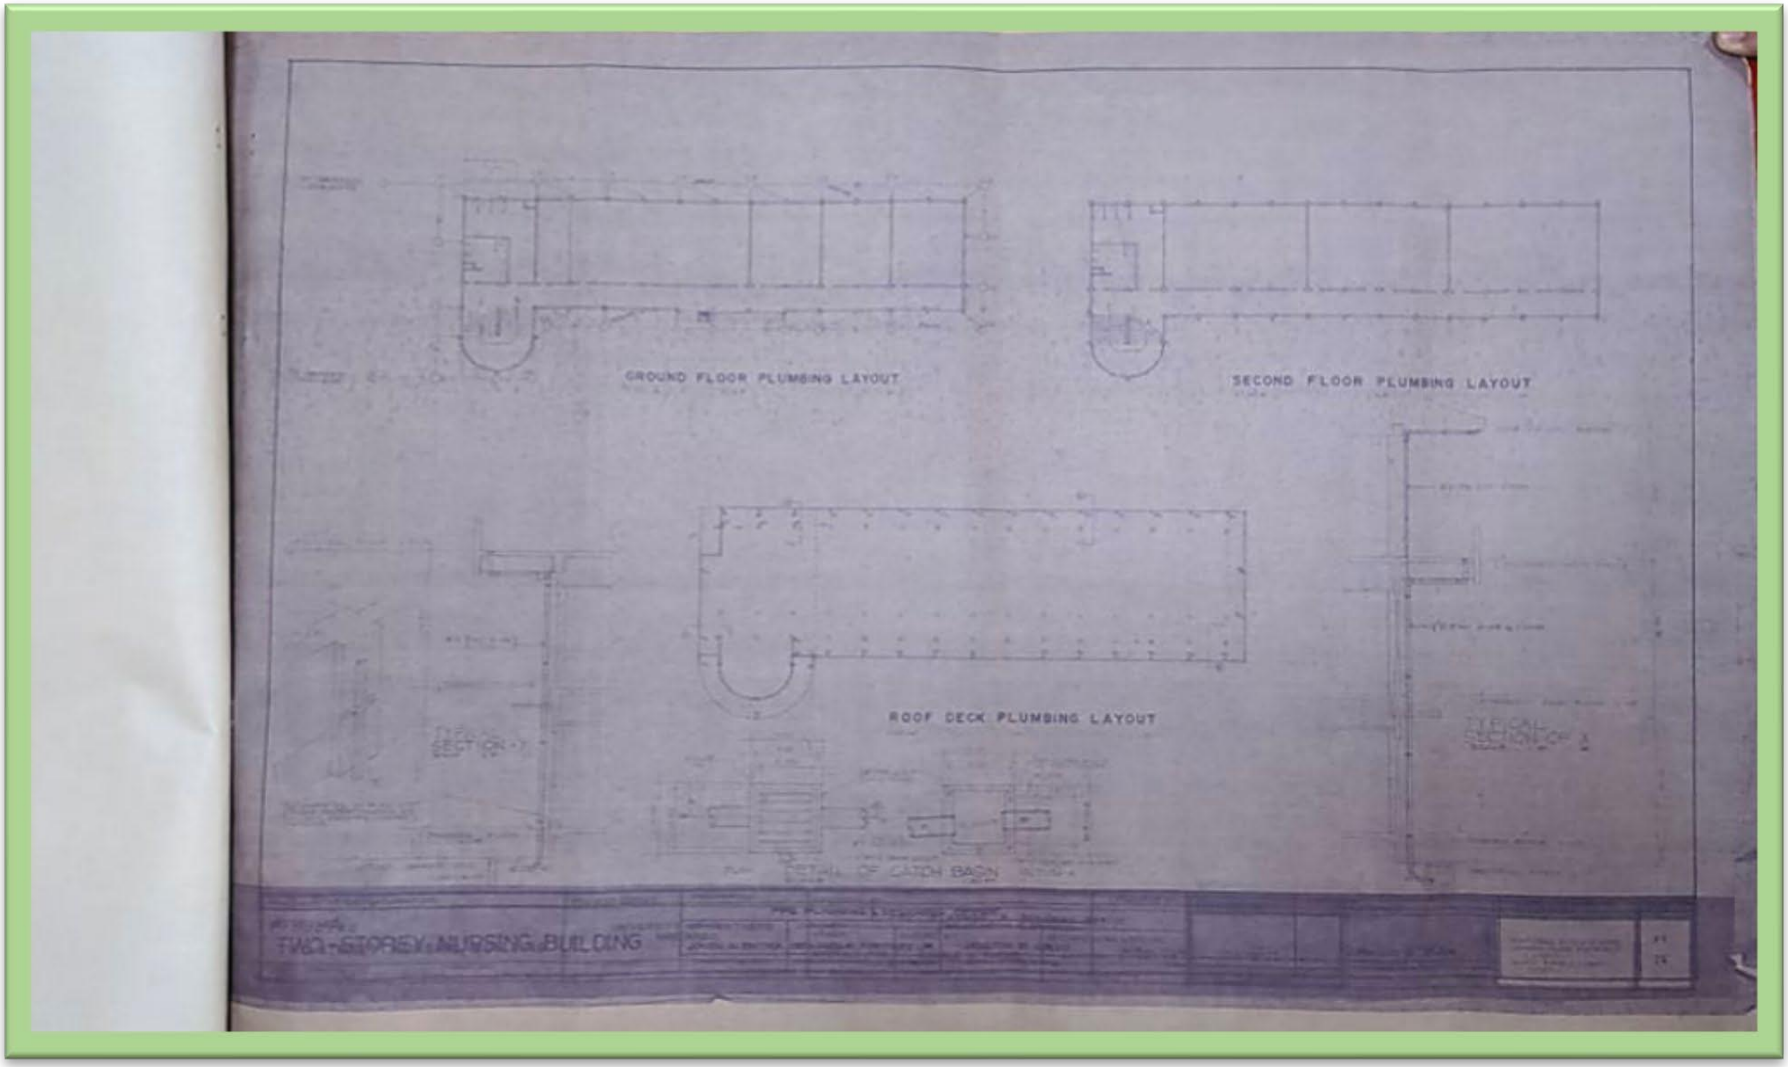
AREA VIII

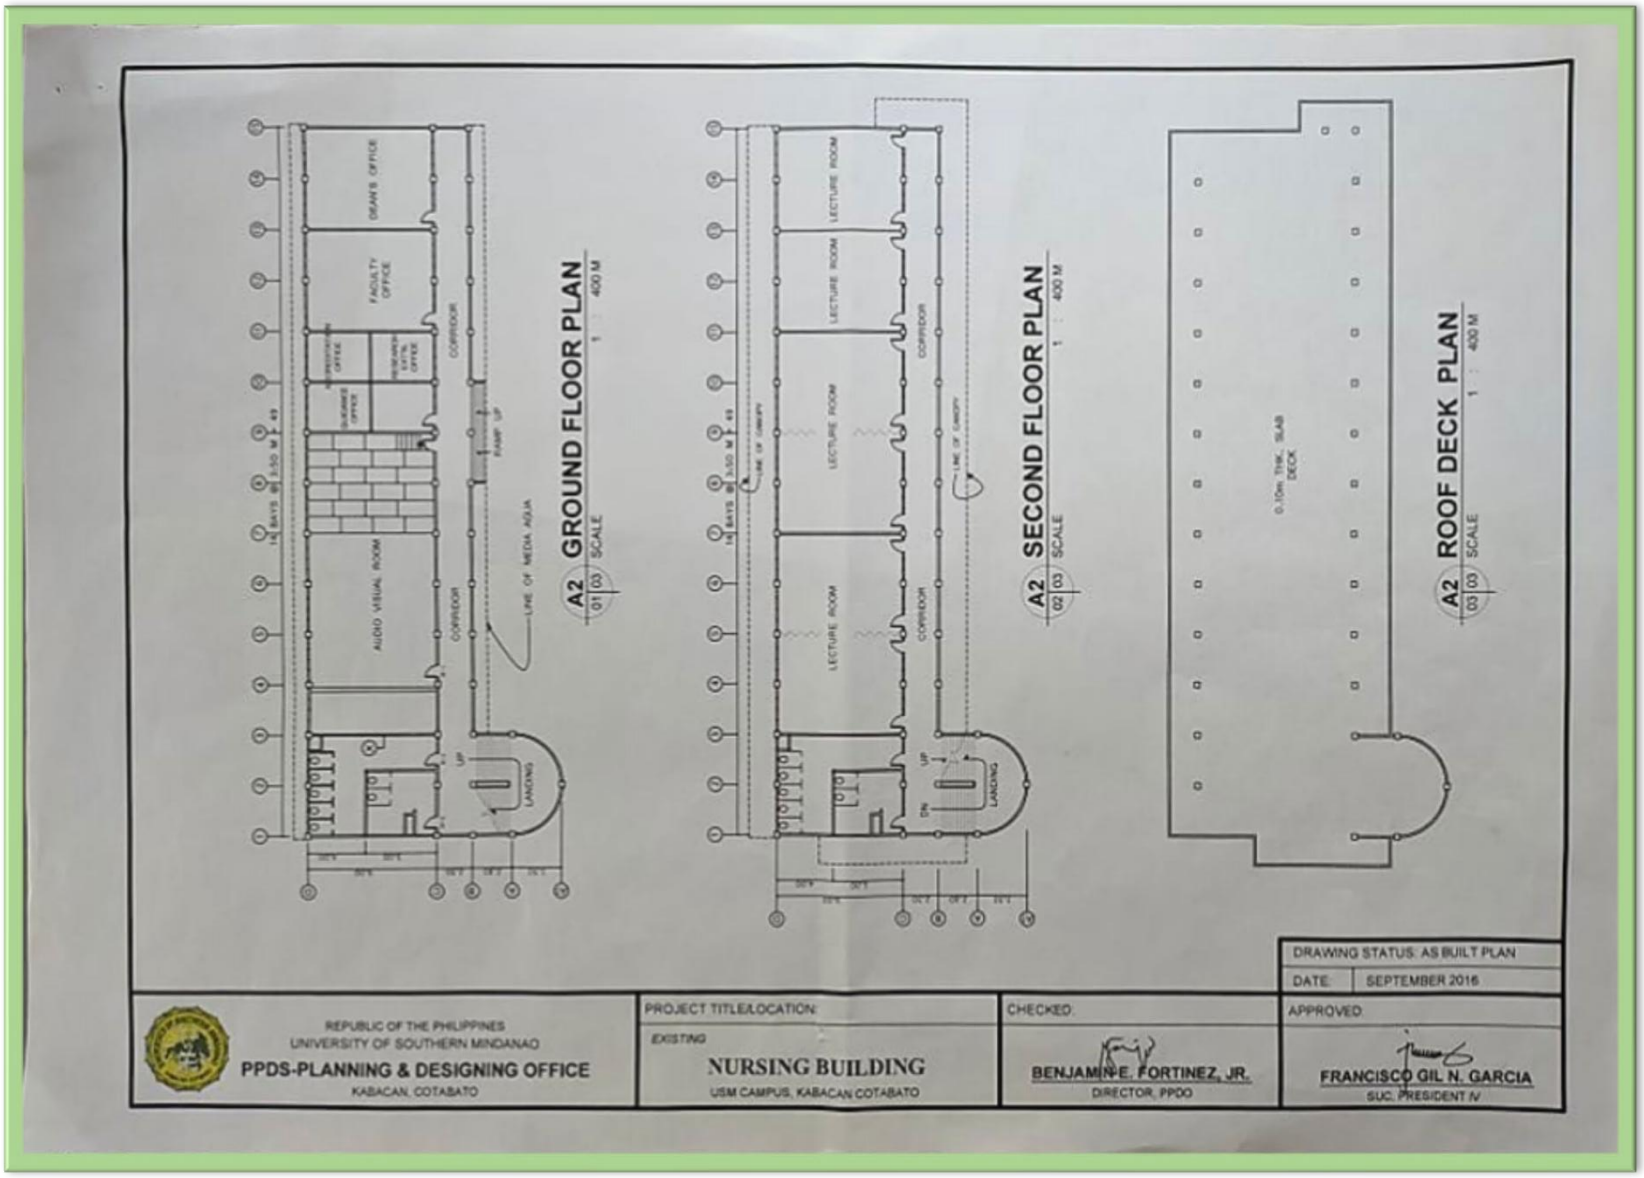
PHYSICAL PLANT AND FACILITIES

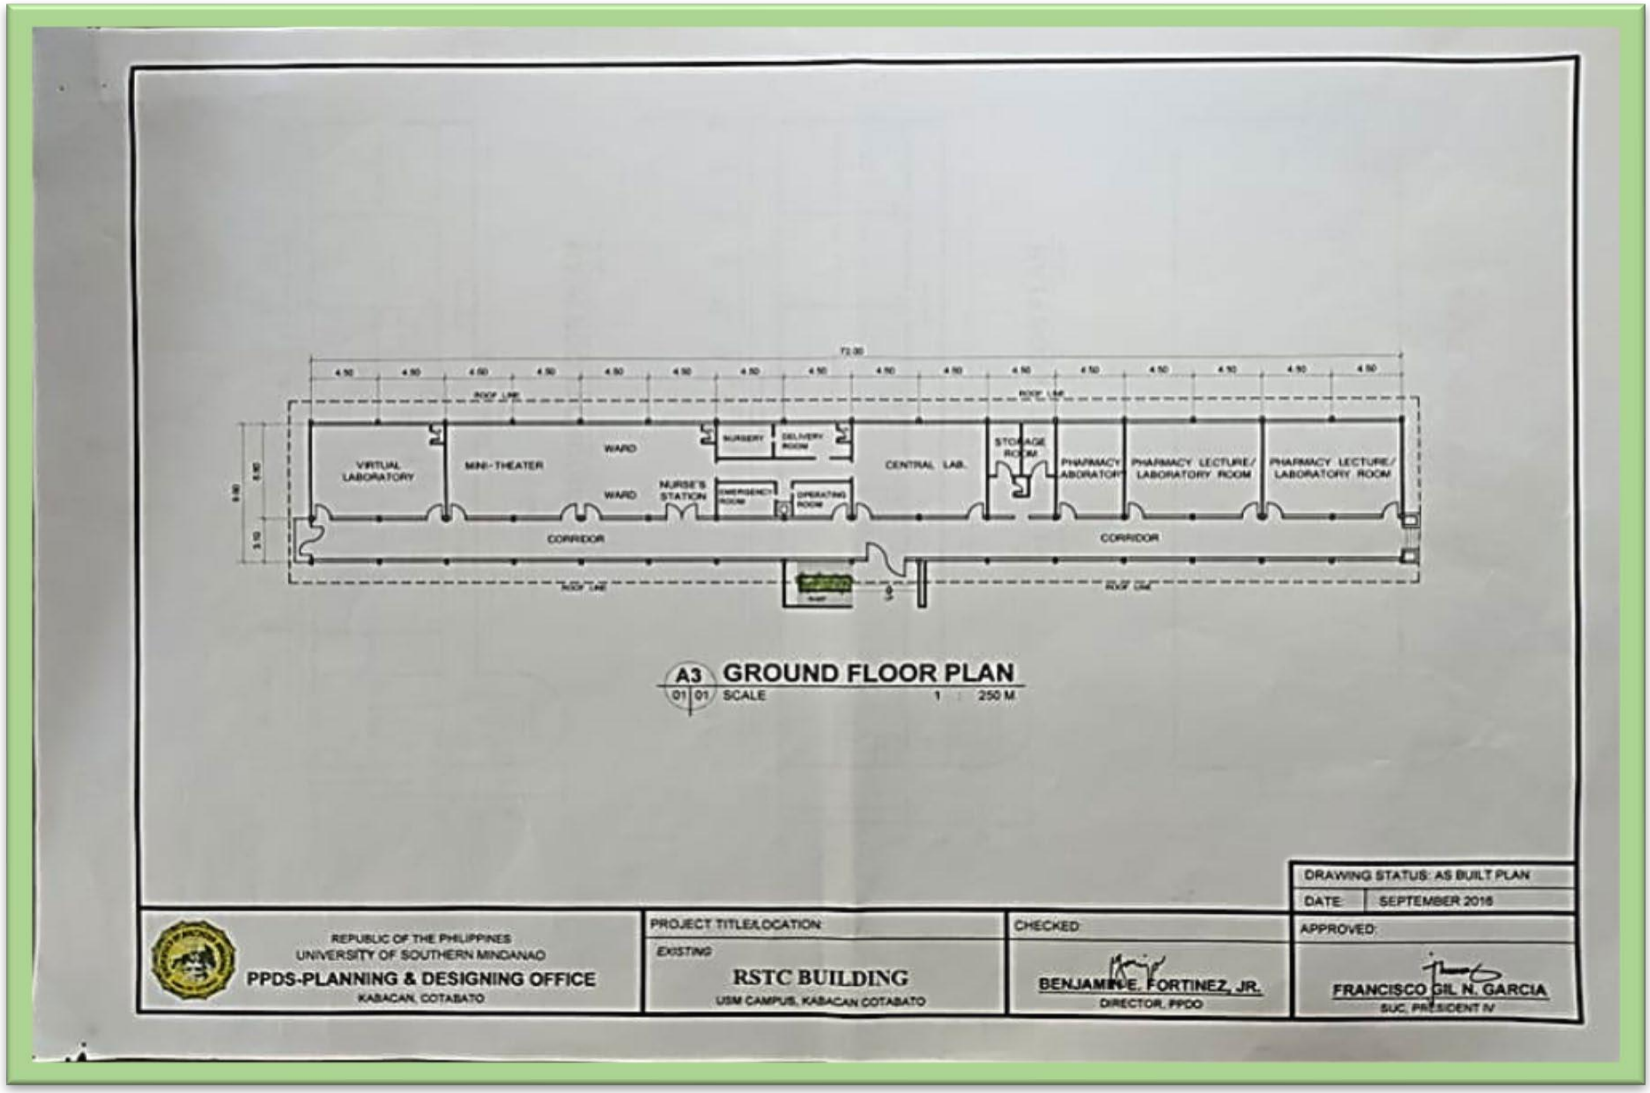
S.2.3. GOOD VENTILATION AND LIGHTING

S.2.3. good ventilation and lighting




GROUND FLOOR PLUMBING LAYOUT
SECOND FLOOR PLUMBING LAYOUT
ROOF DECK PLUMBING LAYOUT
DETAIL OF CATCH BASIN
TWO-STOREY NURSING BUILDING


A2 01 03 GROUND FLOOR PLAN
SCALE 1 : 400 M
A2 02 03 SECOND FLOOR PLAN
SCALE 1 : 400 M
A2 03 03 ROOF DECK PLAN
SCALE 1 : 400 M
DRAWING STATUS: AS BUILT PLAN
DATE: SEPTEMBER 2016
REPUBLIC OF THE PHILIPPINES
UNIVERSITY OF SOUTHERN MINDANAO
PPDS-PLANNING & DESIGNING OFFICE
KABACAN, COTABATO
PROJECT TITLE/LOCATION:
EXISTING
NURSING BUILDING
USM CAMPUS, KABACAN COTABATO
CHECKED:
BENJAMIN E. FORTINEZ, JR.
DIRECTOR, PPDO
APPROVED:
FRANCISCO GIL N. GARCIA
SUC. PRESIDENT IV


72.00
4.50
INDOOR LINE
ROOF LINE
VIRTUAL LABORATORY
MINI-THEATER
WARD
WARD
NURSE'S STATION
NURSERY
DELIVERY ROOM
EMERGENCY ROOM
OPERATING ROOM
CENTRAL LAB.
STORAGE ROOM
PHARMACY LABORATORY
PHARMACY LECTURE/ LABORATORY ROOM
PHARMACY LECTURE/ LABORATORY ROOM
CORRIDOR
CORRIDOR
A3
GROUND FLOOR PLAN
01 01
SCALE 1 : 250 M
DRAWING STATUS: AS BUILT PLAN
DATE: SEPTEMBER 2016
REPUBLIC OF THE PHILIPPINES
UNIVERSITY OF SOUTHERN MINDANAO
PPDS-PLANNING & DESIGNING OFFICE
KABACAN, COTABATO
PROJECT TITLE/LOCATION:
EXISTING
RSTC BUILDING
USM CAMPUS, KABACAN COTABATO
CHECKED:
BENJAMIN E. FORTINEZ, JR.
DIRECTOR, PPDO
APPROVED:
FRANCISCO GIL N. GARCIA
SUC PRESIDENT IV